





Z PROJECTS, LLC
 1919 MCGINNERY AVE.
 SUITE 110
 DALLAS, TX 75201
 214.908.3488
 WWW.ZPROJECTS.COM

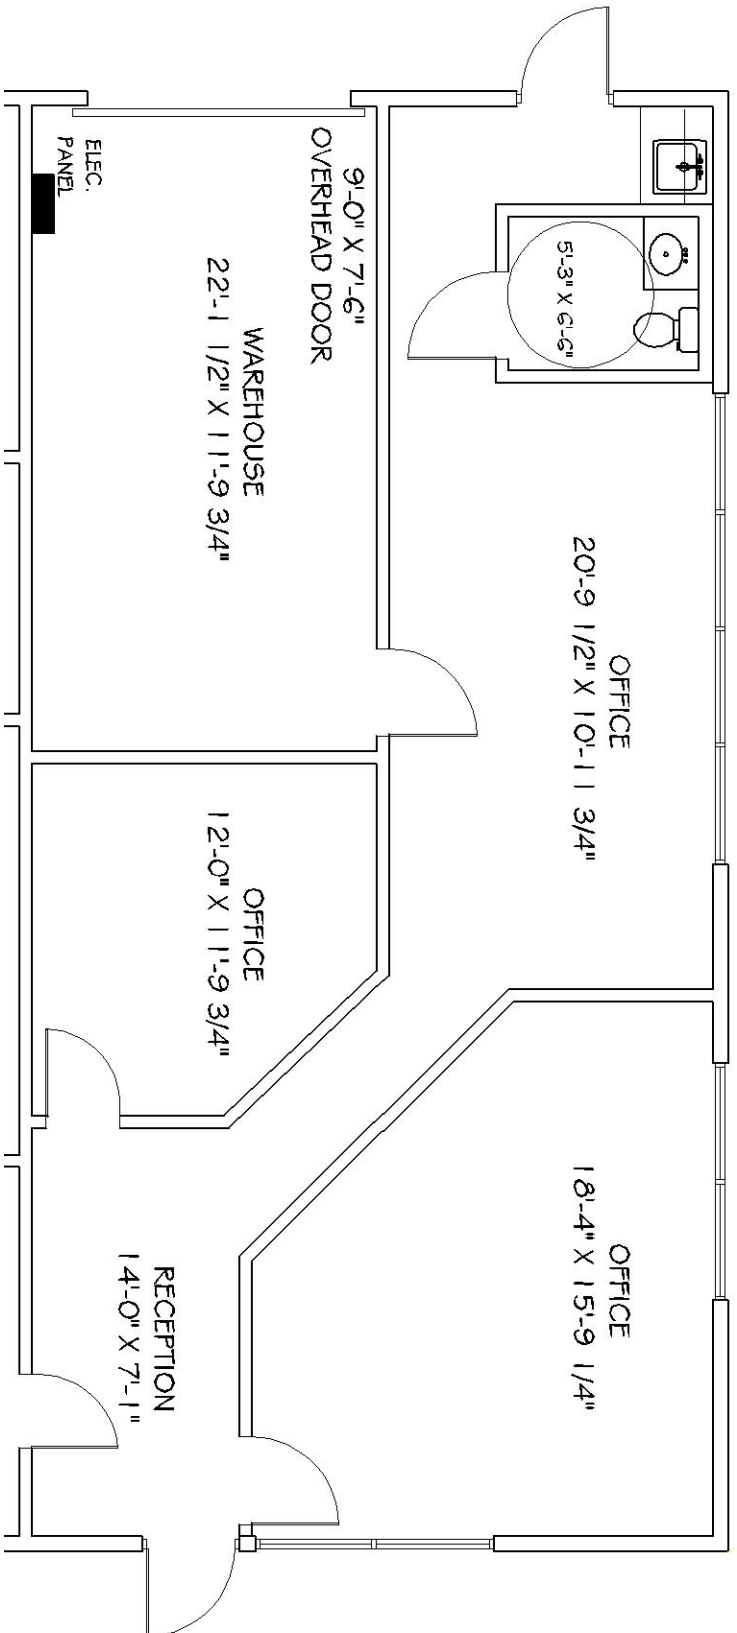

KEY PLAN

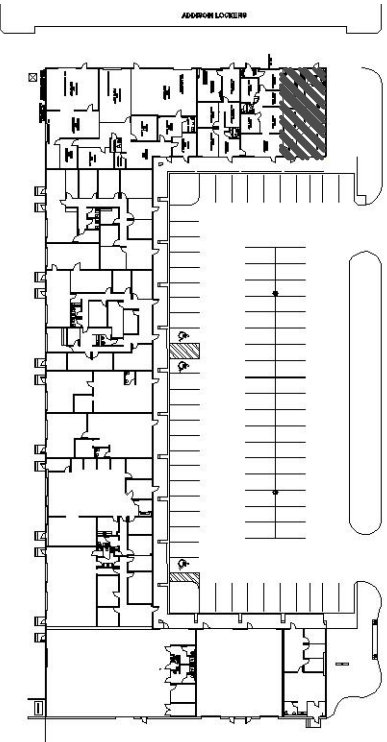

ROBERT B. POWELL, CCIM
 POWELL REALTY ADVISORS, LLC.

214-908-3488
 Robert.Powell@PowellRealtyAdvisors.com

AIRPORT PLAZA

SUITE 119 | 1,200 SF
 4500 RATLIFF | ADDISON, TX 75001

AS BUILT

06/15/2020